


OPENING SCHEDULE

OPENING SCHEDULE

Table with columns: #, Type, Size, Door Information (Finish, Frame, Mullion), Frame Information (Type, Head, Jamb, Sill, Mullion), and Remarks. Rows 1501-1599.

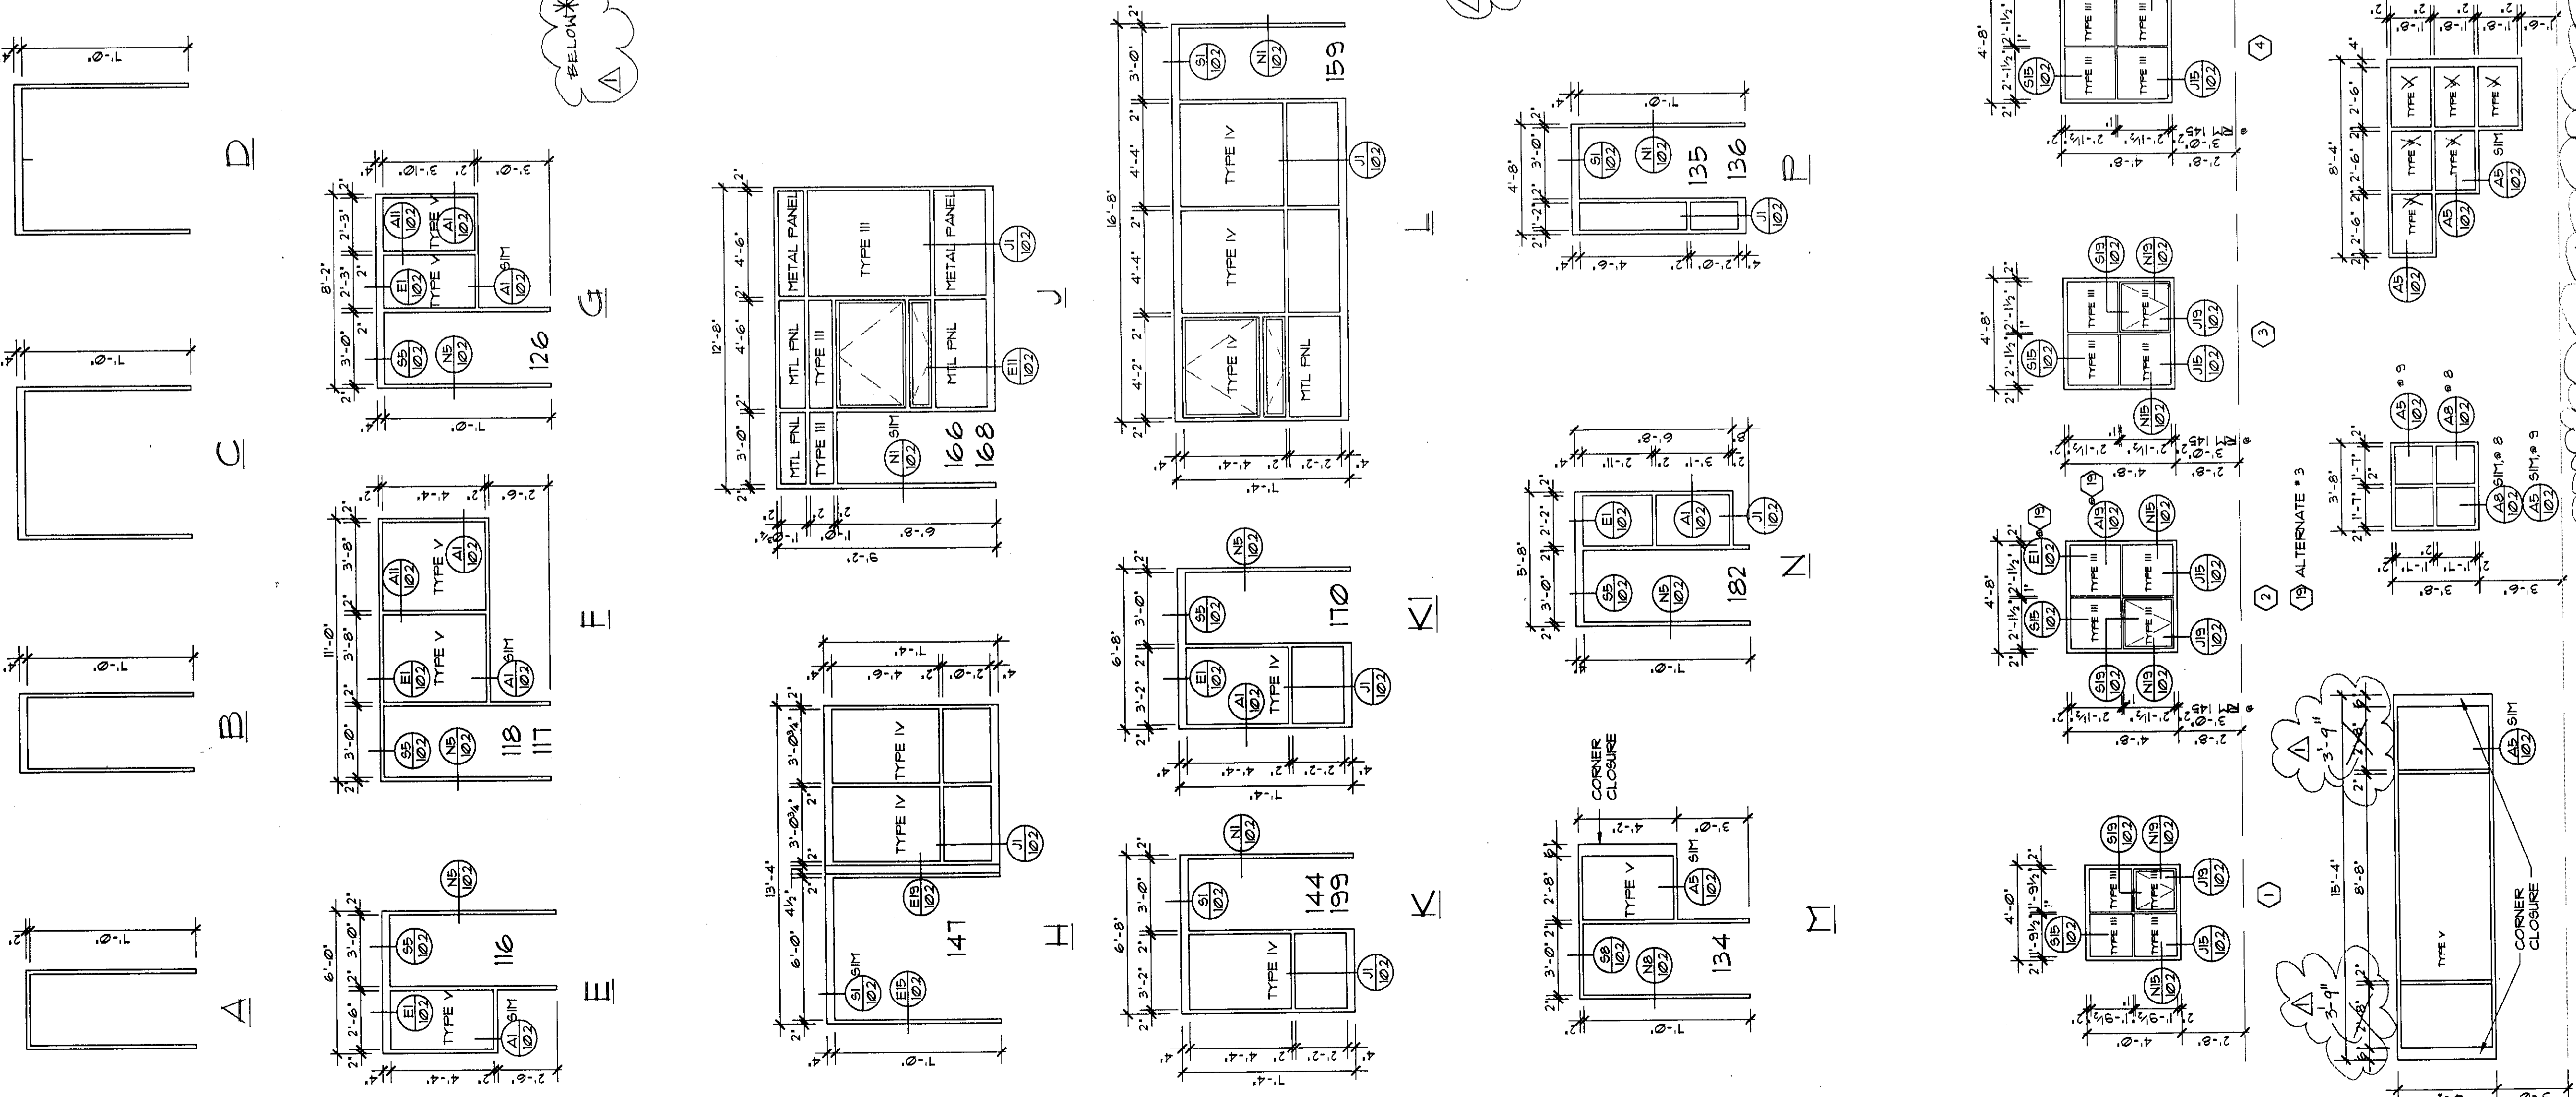

POUDRE R-1 SCHOOL DISTRICT  
ADDITON & REMODEL  
FT. COLLINS, COLORADO

RBB

JOB NUMBER: 9119  
DRAWN: KGL  
CHECKED: GAB  
ISSUE: 10/27/92  
REVISIONS: (none listed)  
SHEET NAME: DOOR SCHEDULE  
SHEET NUMBER: 10.1

THIS RECORD DRAWING IS BASED ON INFORMATION FURNISHED BY THE CLIENT. IT IS THE RESPONSIBILITY OF THE DESIGN PROFESSIONAL CANNOT BE HELD RESPONSIBLE FOR THE ACCURACY OF THIS RECORD DRAWING. THE DESIGN PROFESSIONAL HAS CONDUCTED VISUAL CHECKS OF THIS RECORD DRAWING AND HAS FOUND IT TO BE ACCURATE FOR ITS INTENDED PURPOSE.