



THIS RECORD DRAWING HAS BEEN PREPARED BY THE ARCHITECT FROM INFORMATION FURNISHED BY OTHERS. WHILE THIS INFORMATION IS BELIEVED TO BE CORRECT, THE ARCHITECT ASSUMES NO RESPONSIBILITY FOR THE ACCURACY OF THIS RECORD DRAWING. THE ARCHITECT HAS CONDUCTED VISUAL CHECKS OF THIS RECORD DRAWING WHICH MAY HAVE BEEN INCORPORATED INTO IT AS THIS RECORD DRAWING. THE ARCHITECT HAS ADVISED TO THE CONTRACTOR OF ANY DISCREPANCIES OR OMISSIONS DETECTED AND OF THE ACCURACY BEFORE APPLYING IT FOR ANY PURPOSE.

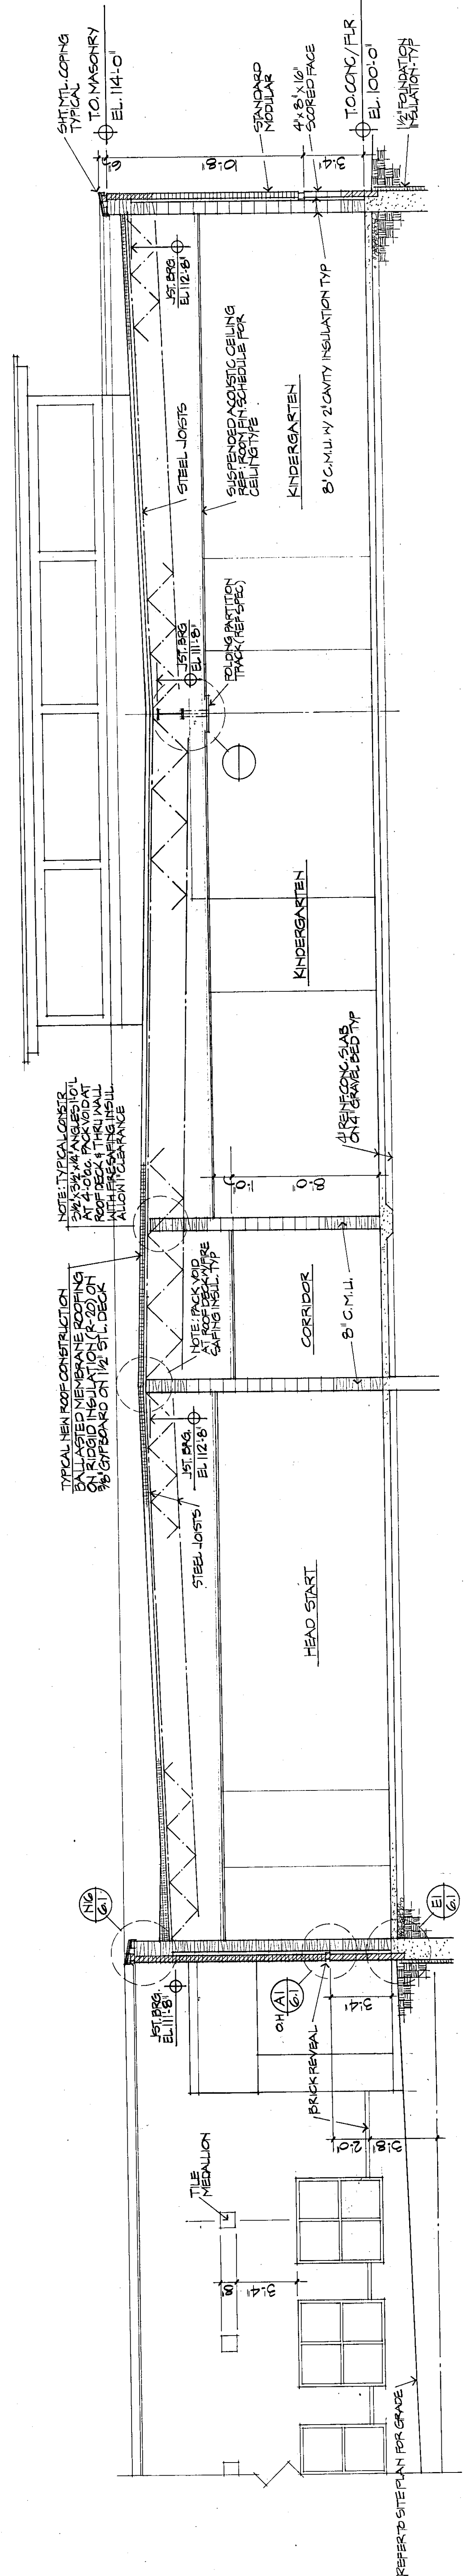


L1
 1/4" = 1'-0"

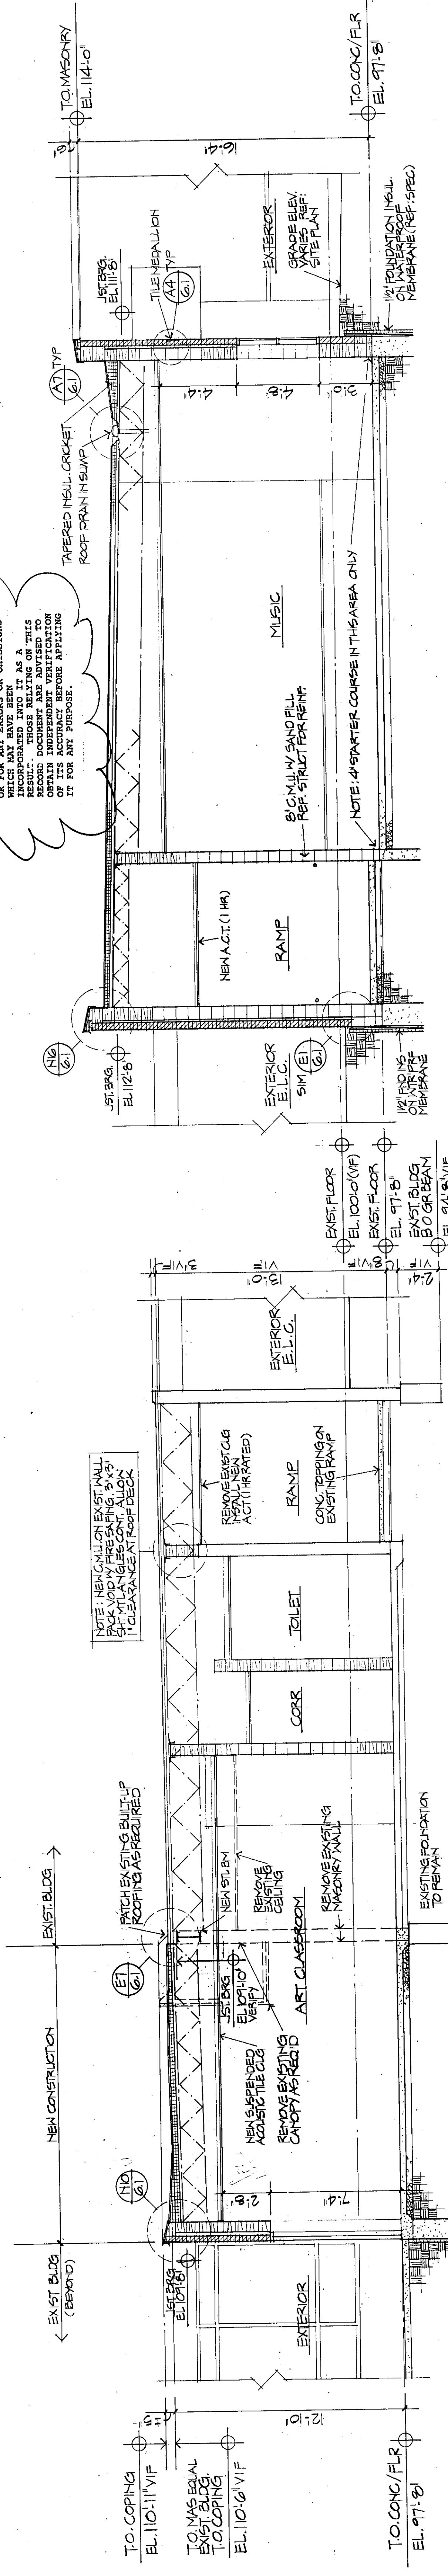

F1
 1/4" = 1'-0"

F12
 1/4" = 1'-0"

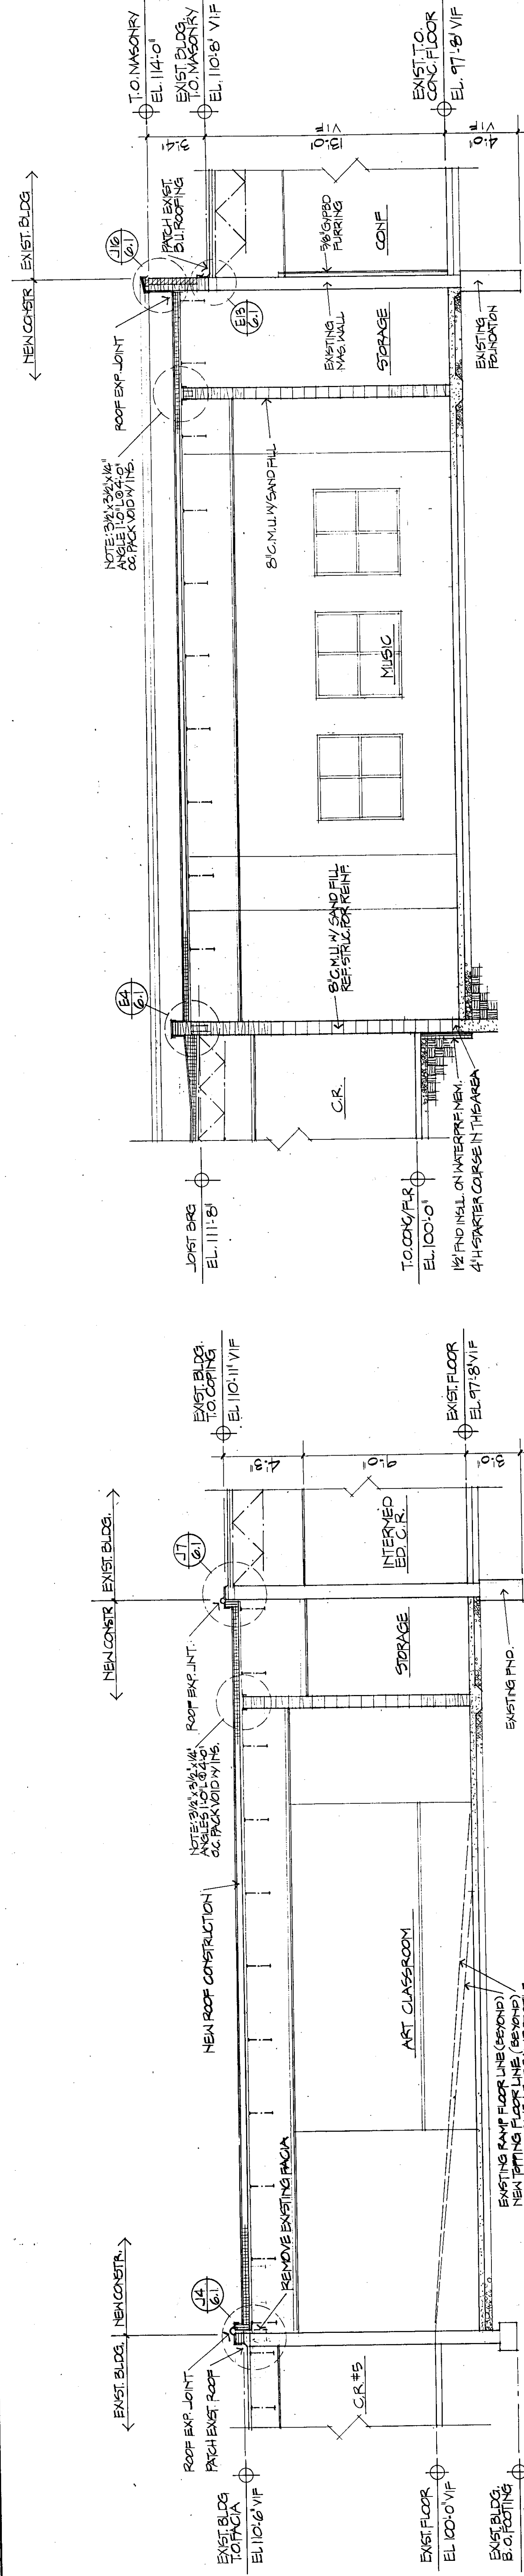

A12
 1/4" = 1'-0"

A12
 1/4" = 1'-0"

BUILDING SECTION

BUILDING SECTION