



L1 1/4"=1'-0" BUILDING SECTION

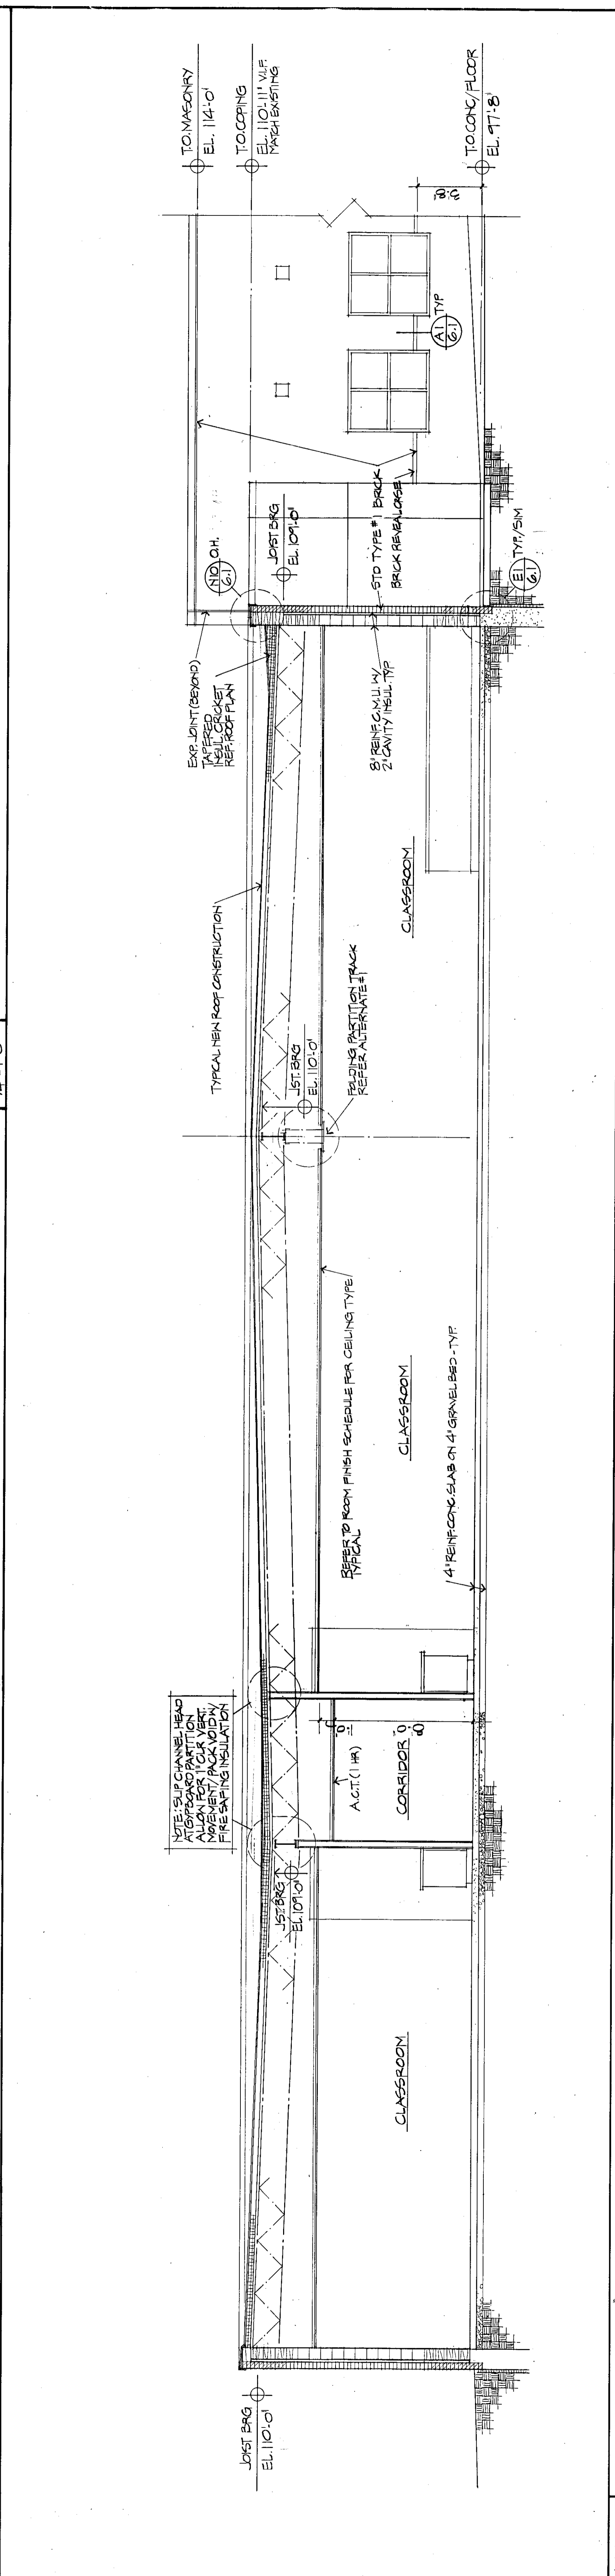

F1 1/4"=1'-0" BUILDING SECTION

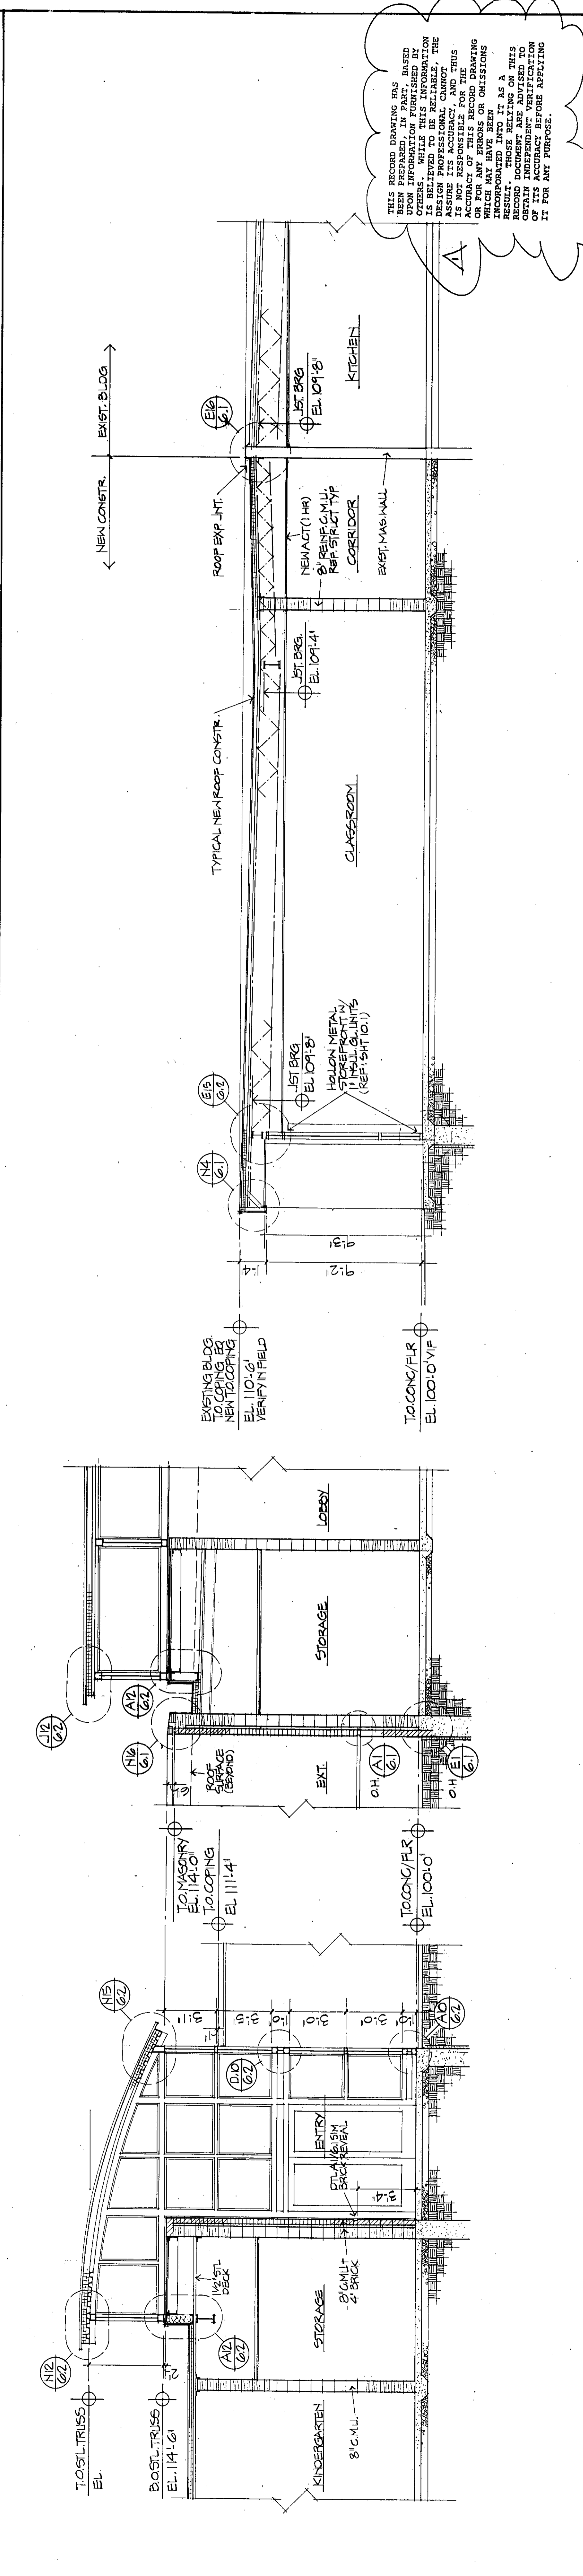

A1 1/4"=1'-0" BUILDING SECTION

THIS RECORD DRAWING HAS BEEN PREPARED BY THE ARCHITECT UPON INFORMATION FURNISHED BY THE DESIGN PROFESSIONAL. THE DESIGN PROFESSIONAL CANNOT BE HELD RESPONSIBLE FOR THE RESULTS OF THIS RECORD DRAWING WHICH MAY HAVE BEEN USED FOR ANY OTHER PURPOSES. THE DESIGN PROFESSIONAL IS NOT RESPONSIBLE FOR THE RESULTS OF THIS RECORD DRAWING WHICH MAY HAVE BEEN USED FOR ANY OTHER PURPOSES.