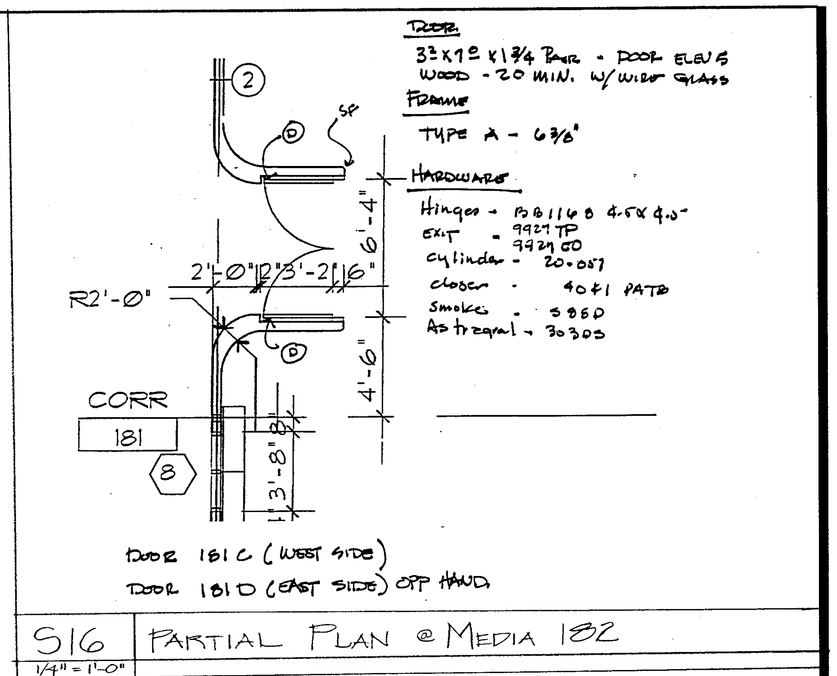

S16 | PARTIAL PLAN @ MEDIA 182

1/4" = 1'-0"

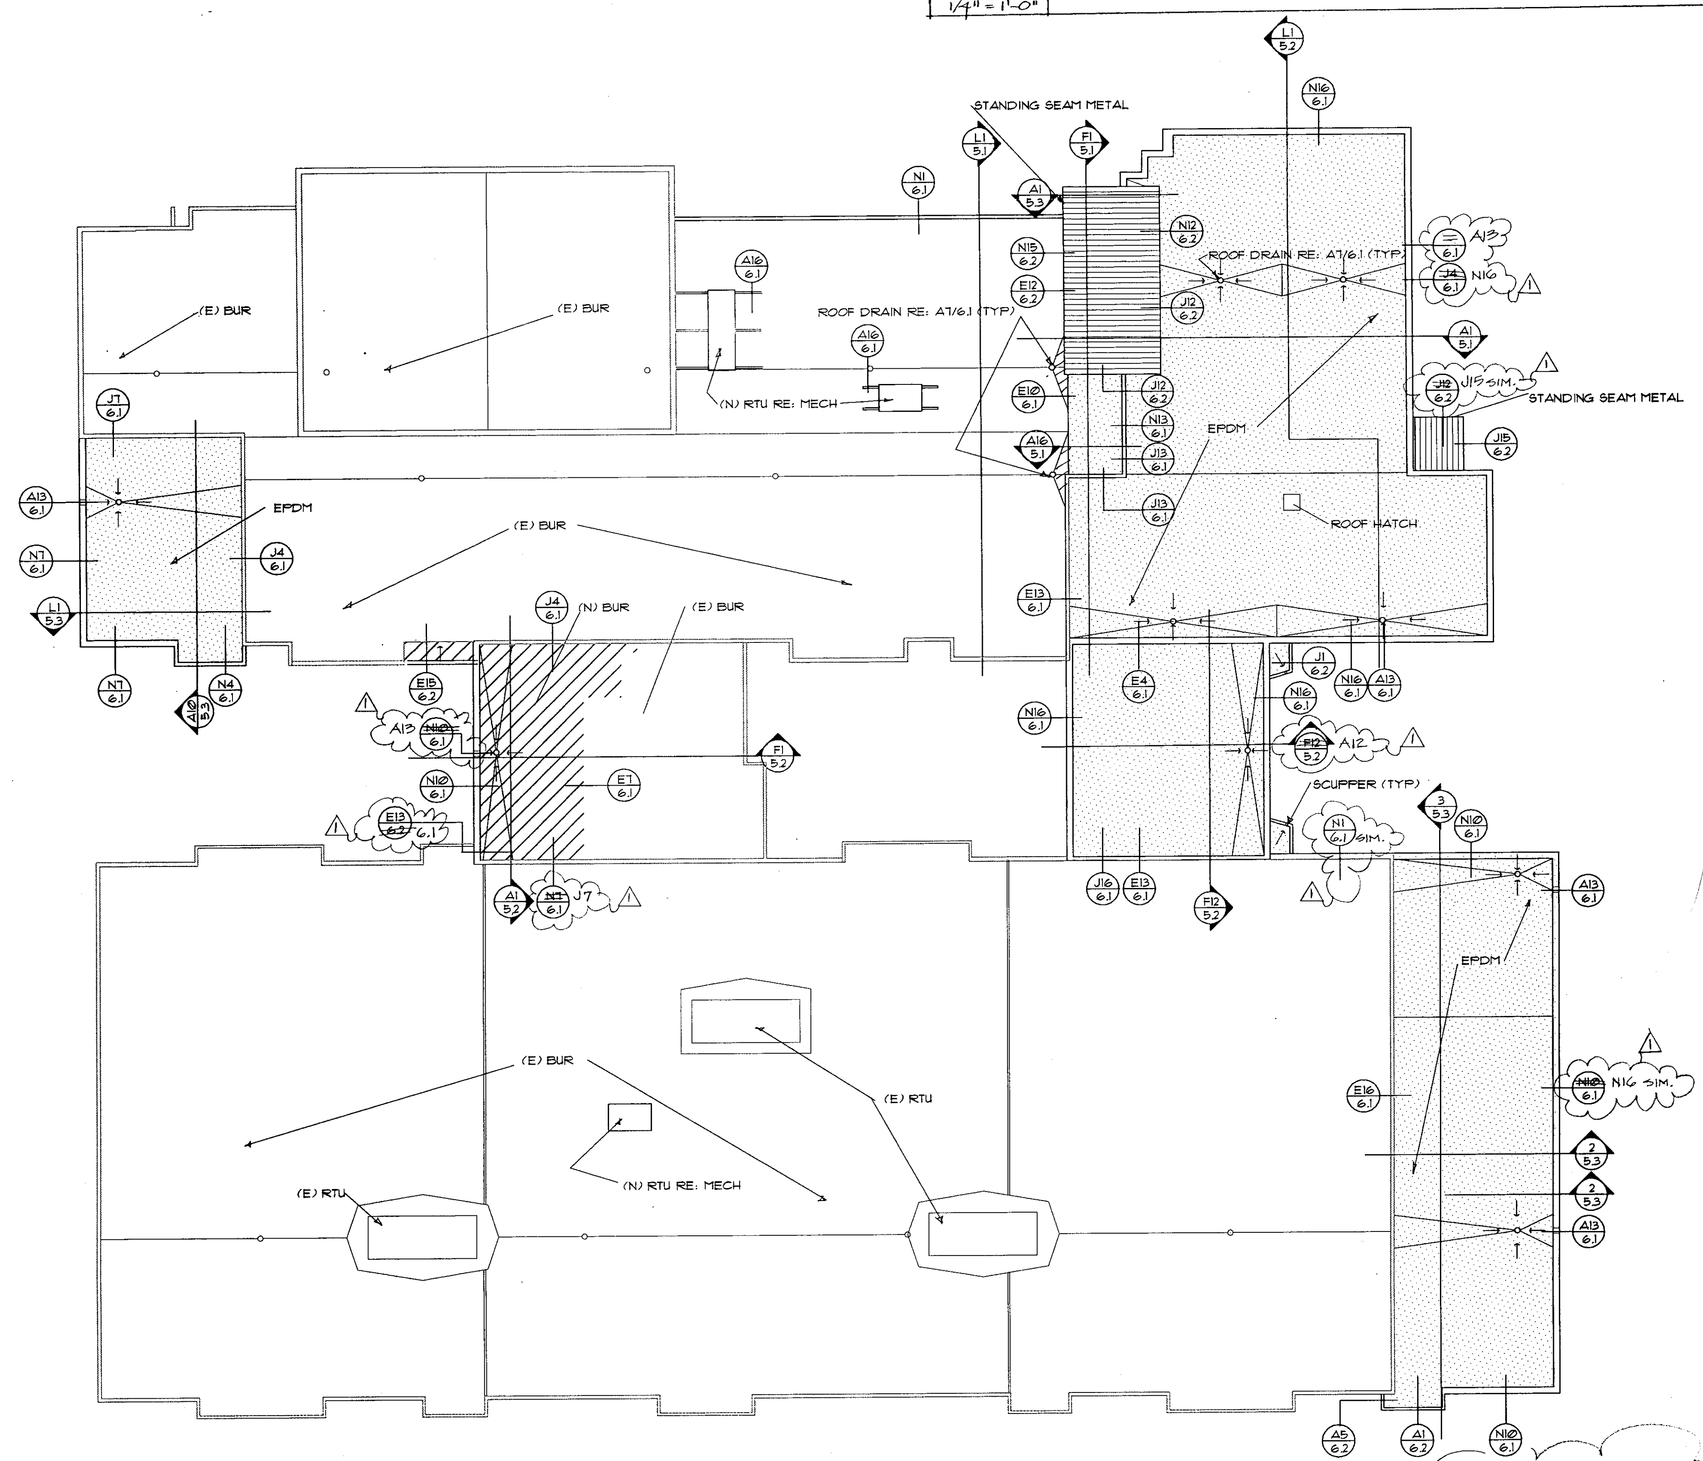

THIS RECORD DRAWING HAS BEEN PREPARED, IN PART, BASED UPON INFORMATION FURNISHED BY OTHERS. WHILE THIS INFORMATION IS BELIEVED TO BE RELIABLE, THE DESIGN PROFESSIONAL CANNOT ASSURE ITS ACCURACY, AND THUS IS NOT RESPONSIBLE FOR THE ACCURACY OF THIS RECORD DRAWING OR FOR ANY ERRORS OR OMISSIONS WHICH MAY HAVE BEEN INCORPORATED INTO IT AS A RESULT. THOSE RELYING ON THIS RECORD DOCUMENT ARE ADVISED TO OBTAIN INDEPENDENT VERIFICATION OF ITS ACCURACY BEFORE APPLYING IT FOR ANY PURPOSE.

A8 | ROOF PLAN

1/16"=1'-0"

POUDRE R-1 SCHOOL DISTRICT

CACHE LA POUDRE ELEMENTARY

ADDITION & REMODEL

FT. COLLINS, COLORADO

Robb, Brenner, and Breig, Inc.
125 S. Howes - Suite 880
Fort Collins, CO 80521

RBB

JOB NUMBER
9113

DRAWN
KMH

CHECKED
GAB

ISSUE
10/07/92

REVISIONS
1 AS BUILTS

SHEET NAME
ROOF PLAN

SHEET NUMBER
3.5