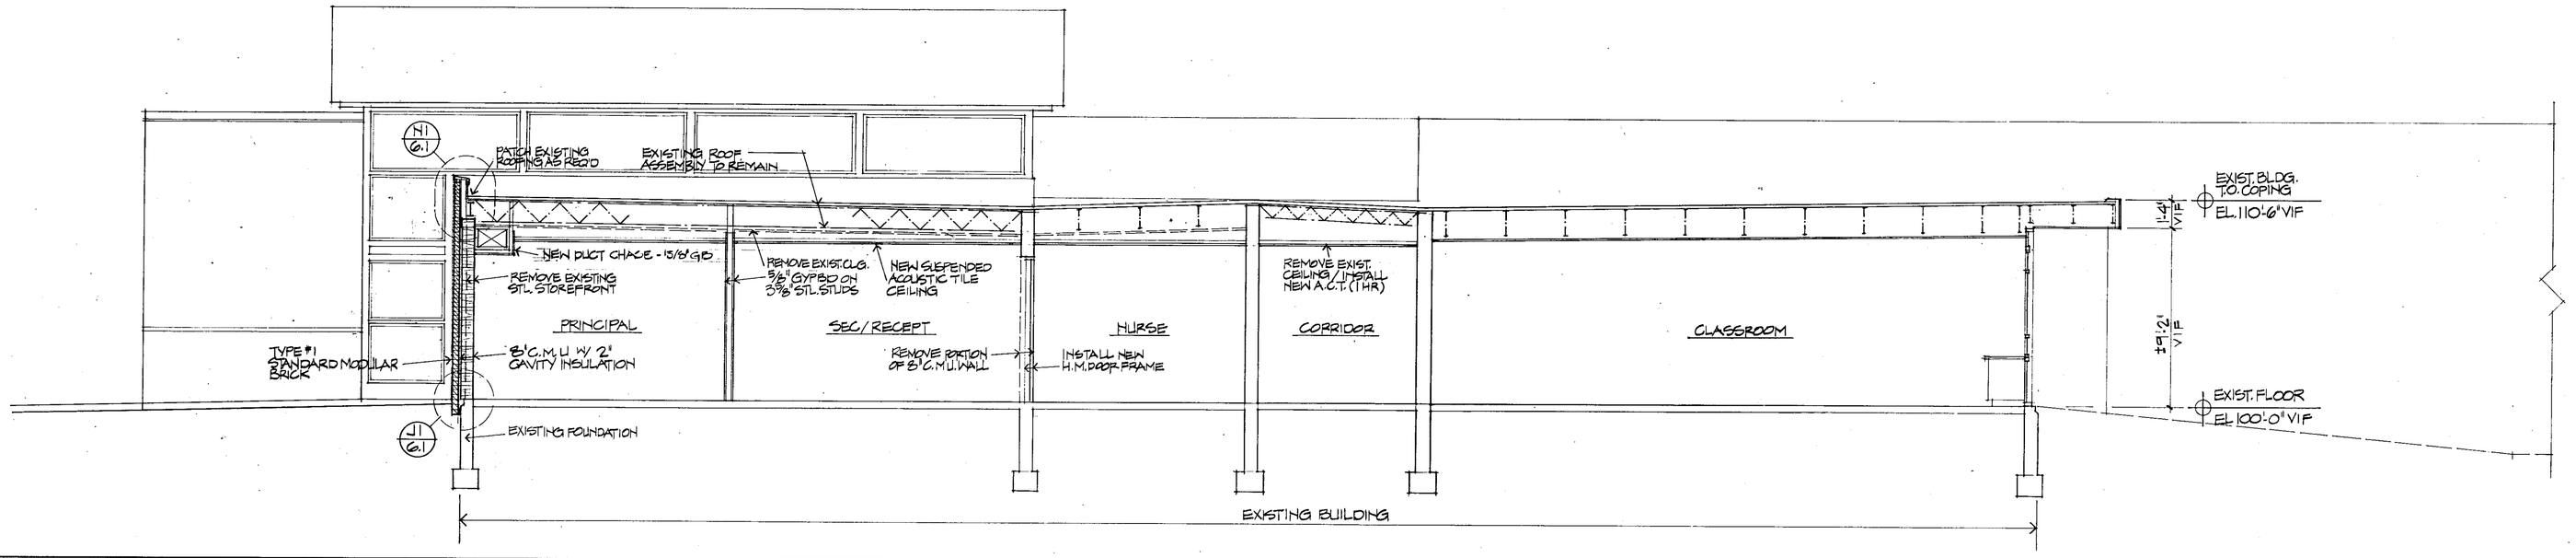

L1 — BUILDING SECTION

1/4" = 1'-0"

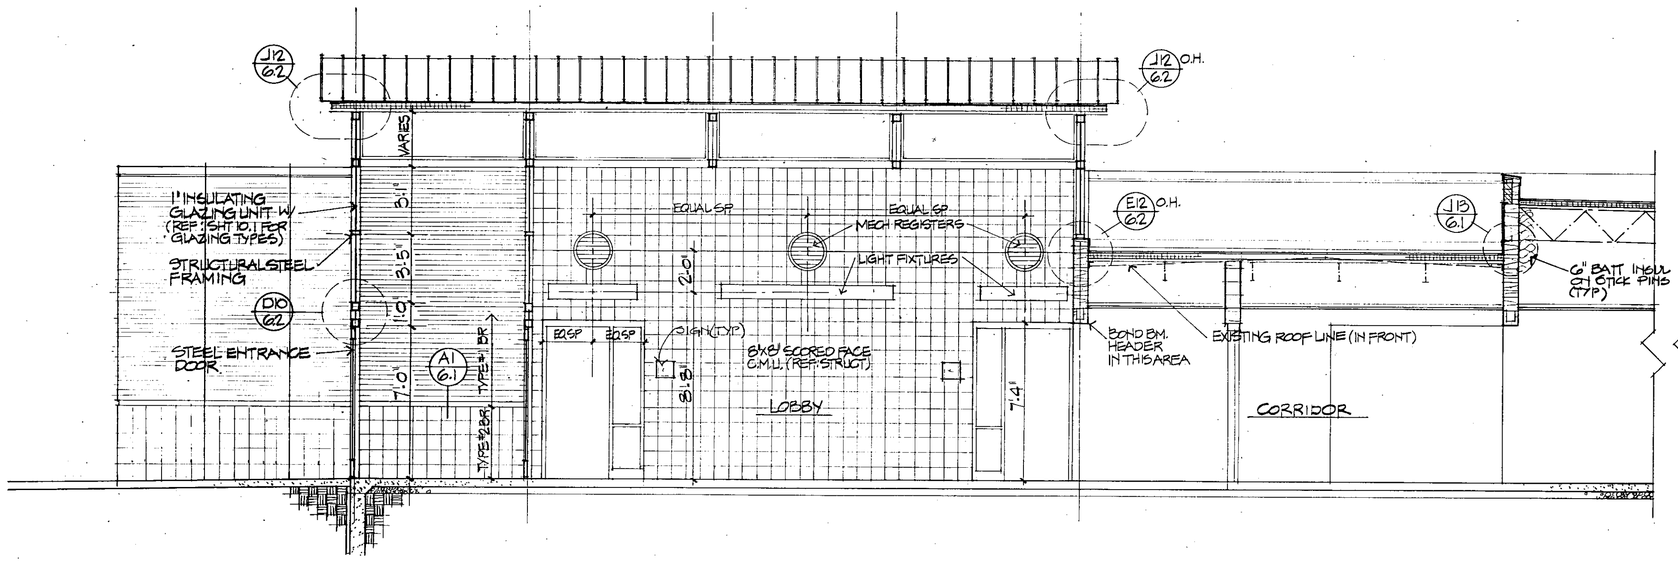

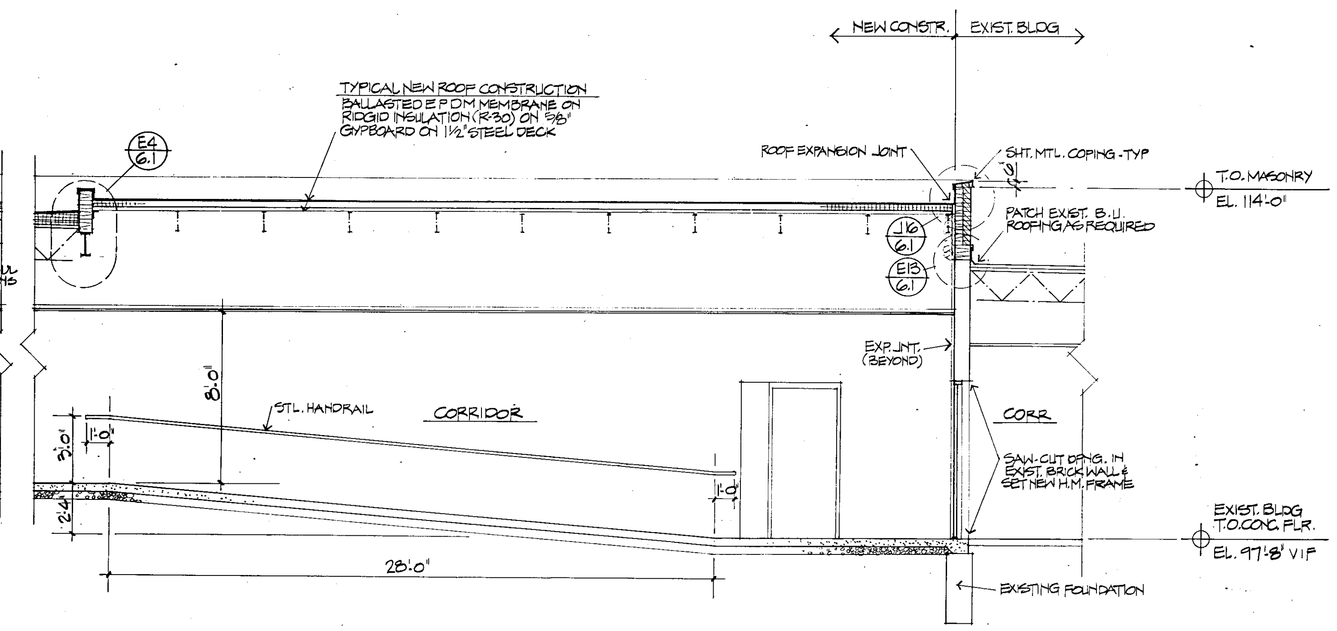

F1 — BUILDING SECTION

1/4" = 1'-0"

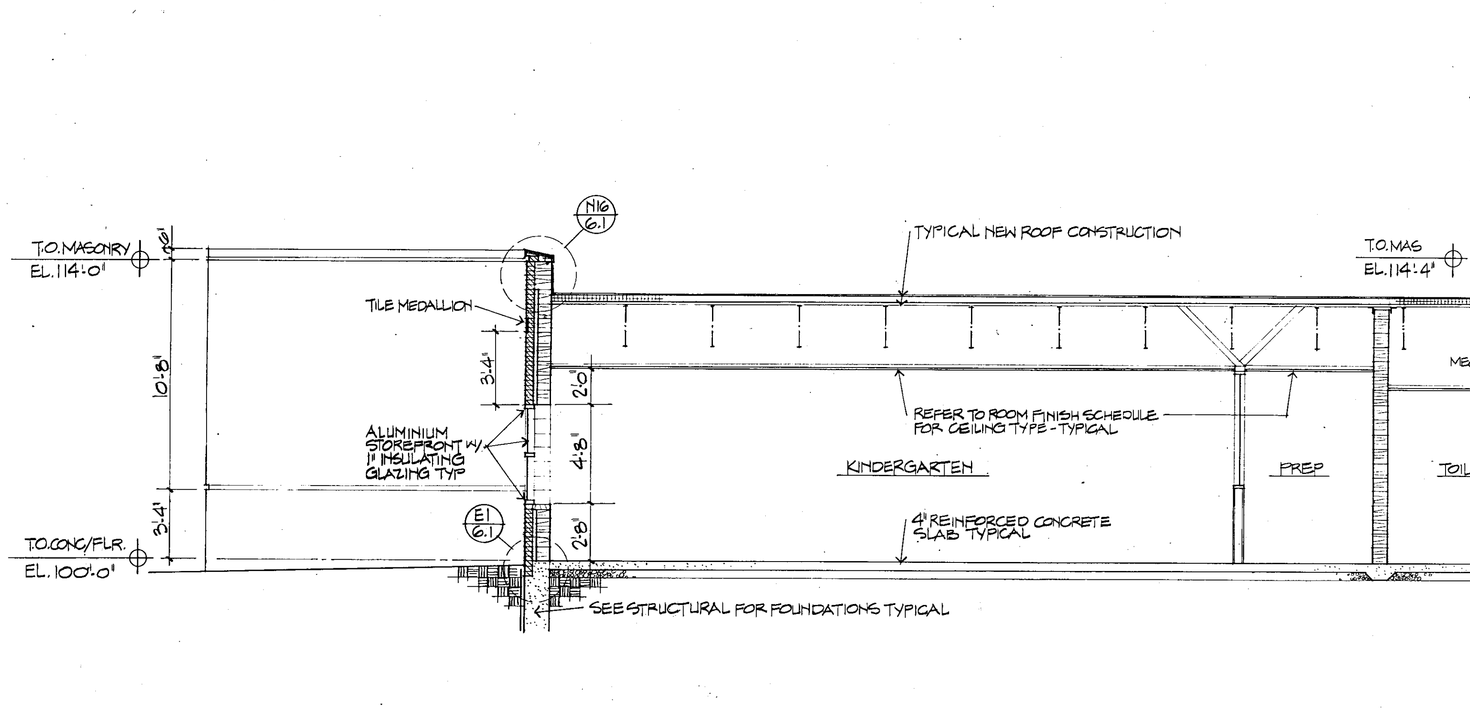

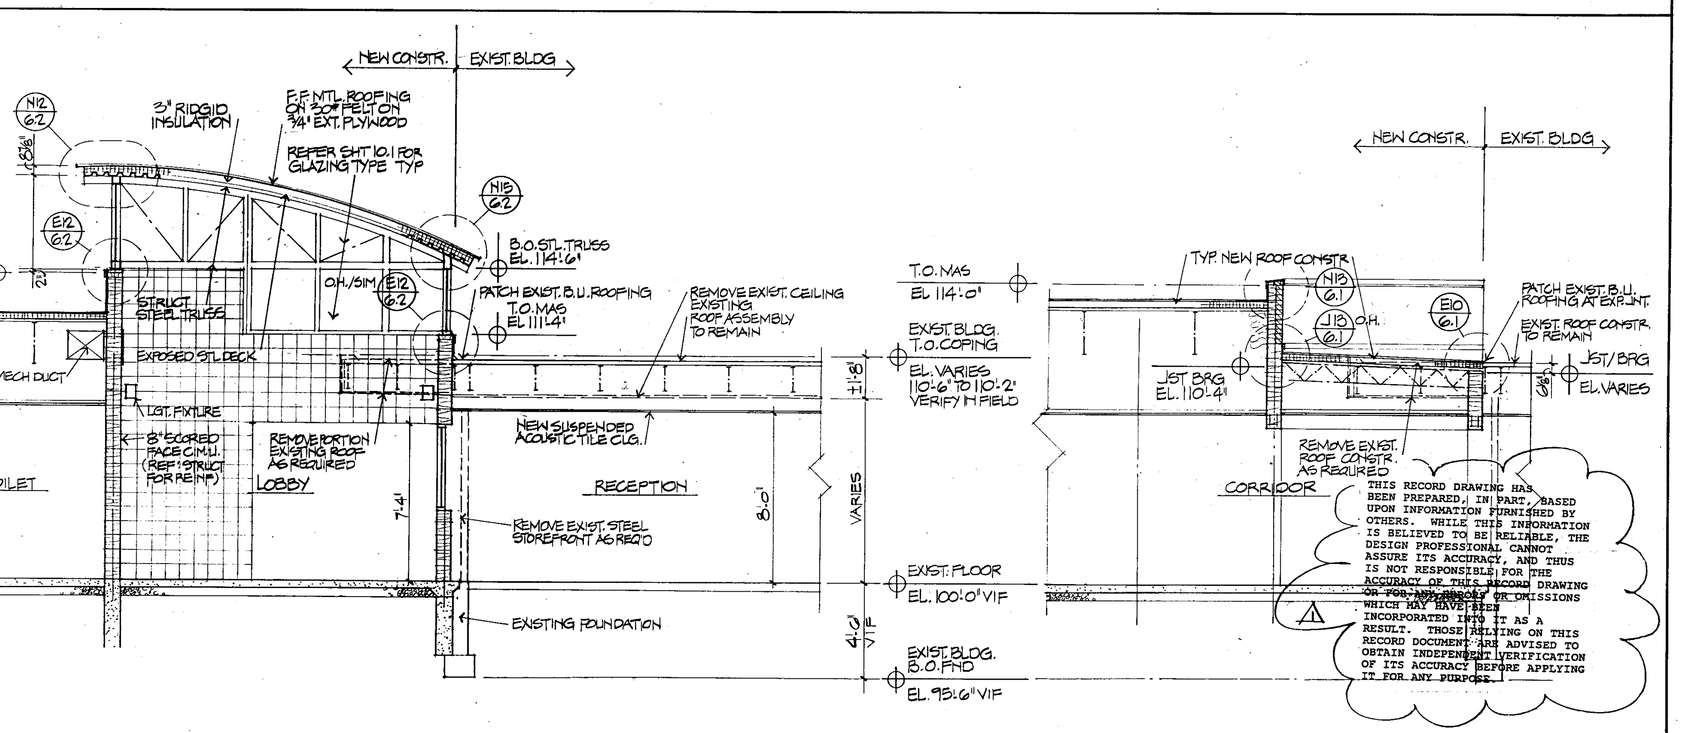

A1 — BUILDING SECTION

1/4" = 1'-0"

A16 — BUILDING SECTION

1/4" = 1'-0"

POUDRE R-1 SCHOOL DISTRICT

CACHE LA POUDRE ELEMENTARY

ADDITION & REMODEL

FT. COLLINS, COLORADO

Robb, Brenner, and Breig, Inc.
125 S. Howes - Suite 880
Fort Collins, CO 80521

RB+B

JOB NUMBER 918

DRAWN CSD

CHECKED GAD

ISSUE 10/07/92

REVISIONS

1 AS BUILTS

SHEET NAME BUILDING SECTIONS

SHEET NUMBER 5.1