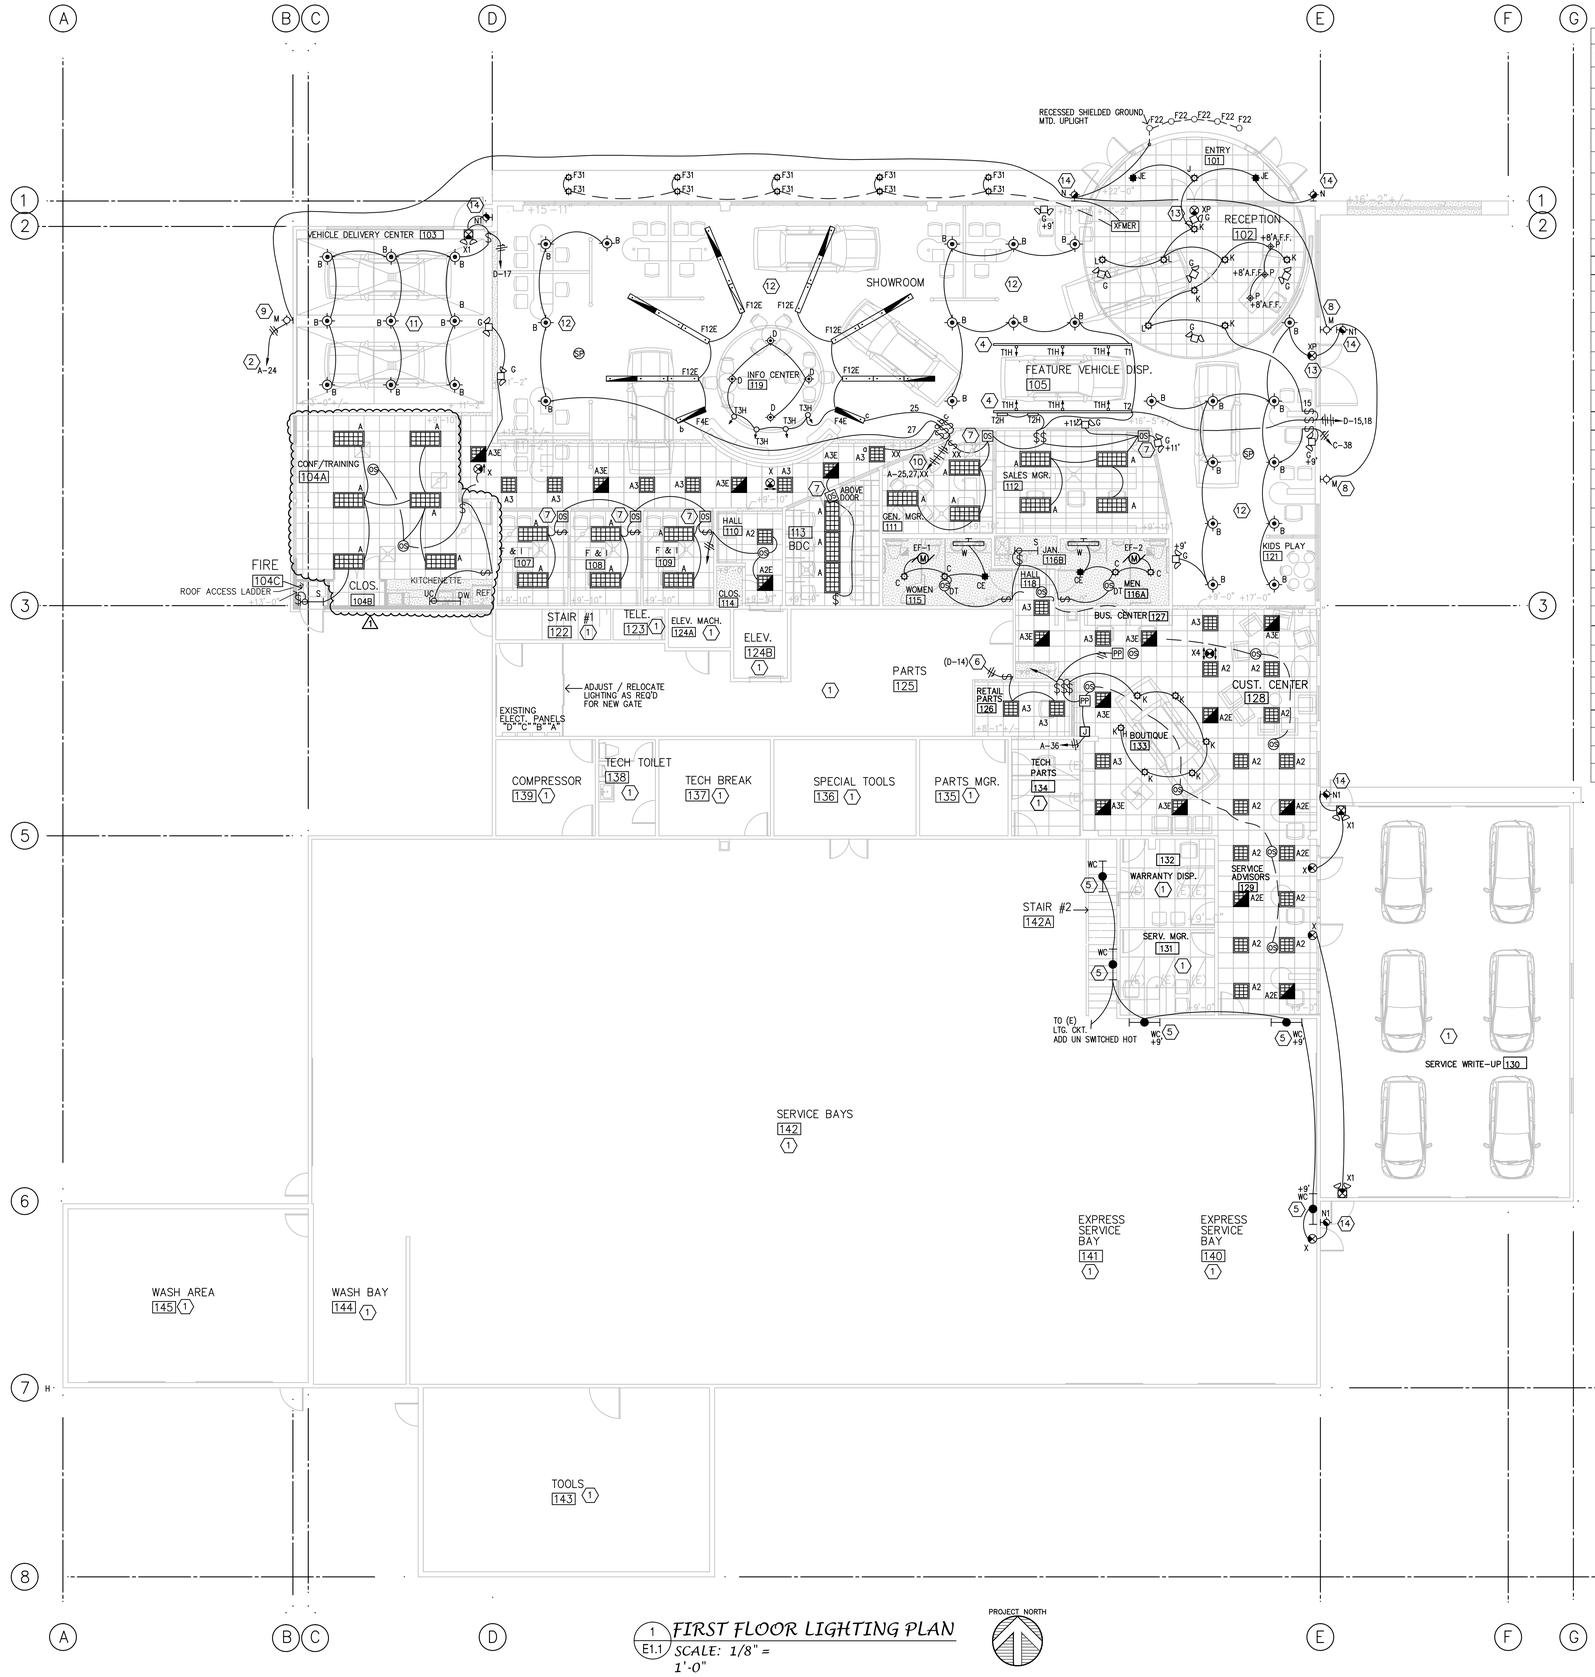

1 / E1.1 FIRST FLOOR LIGHTING PLAN
SCALE: 1/8" = 1'-0"

LUMINARE SCHEDULE

COUNTS	SYMBOL	TYPE	MANUFACTURER (OR APPROVED EQUAL)	CATALOG OR MODEL NUMBER	LAMP(S) NUMBER	VOLTAGE	WATTS	MOUNTING	REMARKS
23		A	LITHONIA	2P3MN-G-2-32-12LD-MVOLT-GEB10IS PWS1836LP741	(2)F32W T8	MVOLT	58	RECESSED	2'x4'
13		A2	LITHONIA	2P3MN-G-2-17-9LD-MVOLT-GEB10IS PWS1836LP741	(2) F17W T8	MVOLT	32	RECESSED	2X2
5		A2E	LITHONIA	2P3MN-G-2-17-9LD-120V-GEB10IS EL14 PWS1836LP742	(2) F17W T8	120V	32	RECESSED	2X2 W/EM
10		A3	LITHONIA	2P3MN-G-3-17-9LD-MVOLT-I/3-GEB10IS PWS1836LP741	(3) F17W T8	MVOLT	47	RECESSED	2X2
10		A3E	LITHONIA	2P3MN-G-3-17-9LD-120V-I/3-GEB10IS EL14 PWS1836LP742	(3) F17W T8	120V	47	RECESSED	2X2 W/EM
1		A4	LITHONIA	2GT8 2-32-A12 MVOLT-GEB10IS	(2)F32W T8	MVOLT	58	RECESSED	2'x4'
30		B	TROY CLASSIC RLM	2-RD-12-HC-FG	(1)100W MH	120	110	PENDANT ,LENGTHS VARY	12" DIA. STEMLIGHT
4		C	MAXILUME	HH6PL-1x32-E-MVOLT-6501-SHZ SHZ	(1)32W TRT	MVOLT	33	RECESSED	6" CAN
2		CE	MAXILUME	HH6PL-1x32-E-120-NTG 750	(1)32W TRT	120	33	RECESSED	6" CAN W/EM.
1		C1	MAXILUME	HH6PL-1x13-E-MVOLT	(1)13W TRT	MVOLT	33	RECESSED	6" CAN
4		D	LITHONIA	CFV9-18DTT-SAR-120V-PM-DWHG	(1) 18WDTT	MVOLT	25	PENDANT, LENGTHS	8" CYLINDER
2		F4E	PEERLESS	SPM9 2 54T5HO 20/80 WHR 4FT R12 120 BINP 1SE EL65 SCT LP841 F2/48 C032 ACG	(2)54W T5HO	120	110	SUSPENDED	4" INDIRECT-DIRECT W/EMERGENCY
6		F12E	PEERLESS	SPM9 2 54T5HO 20/80 WHR 12FT R12 120 BINP 1SE EL65 SCT LP841 F2/48 C032 ACG	(6)54W T5HO	120	325	SUSPENDED	12" INDIRECT-DIRECT W/EMERGENCY
5		F22	TARGETTI	ICARE LED 50W/33LED/NEUTRAL 120 ANOD ALU FLOOD ANTI-SLIP 9.5°	LED	120-277	50	IN GROUND	RECESSED UPLIGHT
10		F31	B-K LIGHTING	VS LED e23 MFL A6 WHP	LED	120	8	RECESSED	N. EXTERIOR CANOPY
12		G	ISOLITE	MIGN-25-LC-UN	(2)25W MR11	120/277	50	RECESSED IN WALL/CEILING	EMERGENCY
1		J	GOTHAM	ICO 40/45 6AR 40 120 TRW	LED	120	65	RECESSED	6" DOWNLIGHT
2		JE	GOTHAM	ICO 40/45 6AR 40 120 TRW ELR	LED	120	65	RECESSED	6" DOWNLIGHT W/EM.
11		K	LITHONIA	LP6HN 70MPC 609A 120/277 WLP	70W PAR MH	120	94	RECESSED	6" DOWNLIGHT
3		L	LITHONIA	LP6HN 100MPC 609A 120/277 WLP	100W PAR MH	120	118	RECESSED	6" DOWNLIGHT
5		M	LITHONIA	WSQ 150M FT 120 DWHGXD LPI	(1)150MH	120	150	SURFACE	EXTERIOR FIXTURE
6		N	LITHONIA	WSQ 42TRT MD 120 ELDW DWHGXD LPI	(1)42W TRT	120	46	SURFACE	EXT. FIXTURE W/EM.
4		N1	LITHONIA	AFN W EXT	LED	120/277	21	SURFACE	EMERGENCY
3		P	EUREKA	4233-XB CFT32 120 C 60 RC SC CFR	CFT32	120	33	PENDANT MTD. 8' A.F.F.	AT RECEPTION
2		W	LITHONIA	10844RETS BN	(2)28W T5	120	64	SURFACE	4' WALL VANITY
5		WC	LITHONIA	WC 1 32 120 GEB10IS EL	(1)32W T8	120	32	SURFACE	4' WALL EM. FIXTURE
2		S	LITHONIA	S125 MV GEB10IS WGS	(1)25W T8	MVOLT	27	SURFACE	3' STRIP W/WIRE GUARD
1		T1	CON-TECH	(1)LA-10P, (2)LT-8P, (1)LT-2P, (2)LA-2P	-			MTD. ON UNISTRUT	WHITE TRACK
6		T1H	CON-TECH	CTL8029F670MH-P	(1)70W MH	120	70	TRACK	TRACK FIXTURE
1		T2	CON-TECH	(1)LA-208P, (2)LT-28P, (1)LT-22P, (2)LA-202P	-			MTD. ON UNISTRUT	WHITE TRACK
2		T2H	CON-TECH	CTL70G12WW-P	(1)70W CMH	120	70	TRACK	TRACK FIXTURE
4		T3H	CON-TECH	CTL8029F670MH-P / LA1870MHE-P	(1)70W MH	120	70	MONO POINT	TRACK FIXTURE
1		UC	LITHONIA	2UC 1 32 MVOLT GEB10IS	(1)32W T8	MVOLT	32	SURFACE	4' UNDER CABINET
5		X	ISOLITE	EUN-E-M-G-1C	LED	120/277	2	SURFACE	EXIT SIGN
3		X1	ISOLITE	RLC G WW	LED / (2)5W MR16	120/277	9	SURFACE	EXIT SIGN COMBO
1		X4	ISOLITE	EUN-E-M-G-2M	LED	120/277	2	SURFACE	DOUBLE FACE EXIT SIGN
2		XP	ISOLITE	ELT-EM-G-1C-WH	LED	120/277	3	PENDANT	VERIFY PENDANT LENGTH BEFORE

4

GENERAL NOTES:

1. ELECTRICAL CONTRACTOR TO BE INVOLVED WITH THE ENERGY TRUST PROGRAM.
2. 120V CEILING MOUNTED OCCUPANCY SENSORS ARE SENSOR SWITCH CMR-PDT-9. THE LOW VOLTAGE OCCUPANCY SENSORS ARE SENSOR SWITCH CM-9 AND TIE TOGETHER WITH 18-3 L.V. CABLE. ALL POWER PACKS ARE #PP-20. UNLESS OTHERWISE NOTED.
3. ALL EGRESS AND EXIT LIGHTING SHALL BE CONNECTED TO THE SAME NORMAL LIGHTING BRANCH CIRCUIT AHEAD OF THE LIGHTING CONTROL SWITCH LEG. PROVIDE 90 MINUTES OF BACK UP POWER. THE EGRESS ILLUMINATION SHALL BE AT LEAST 1-FOOT CANDLE AT THE WALKING SURFACE LEVEL.

SHEET NOTES:

1. EXISTING LIGHTING TO REMAIN.
2. CONNECT TO EXISTING EXTERIOR LIGHTING CONTROL. PROVIDE UN-SWITCHED HOT LEG FOR EXTERIOR EGRESS.
3. CONNECT TO EXISTING EXTERIOR LIGHTING CONTROL THAT IS LOCATED BY EXISTING PANELS. MODIFY EXISTING LIGHTING CONTROL AS NEEDED.
4. SUSPEND TRACK DOWN TO 15'-6" A.F.F.. MOUNT TRACK ON UNISTRUT.
5. PROVIDE UN-SWITCHED HOT LEG FOR EMERGENCY EGRESS. FIXTURES TO TURN ON ONLY WHEN LOSS OF POWER.
6. REUSE EXISTING LIGHTING CIRCUIT THAT WAS SAFE OFF DURING DEMO.
7. OCCUPANCY SENSOR TO BE MOUNTED AT CEILING LEVEL OF CORNER. SENSOR SWITCH #WVR-16, 120V. PROVIDE #WV BR CEILING BRACKET. TUCK UP CLOSE IN THE CORNER CEILING
8. 13'-8" TO TOP OF FIXTURE.
9. 13'-8" TO TOP OF FIXTURE.
10. USE AVAILABLE 1P 20A CIRCUIT IN PANEL. CREATE AS-BUILT PANEL SCHEDULE AT COMPLETION OF PROJECT.
11. "B" FIXTURES TO BE 12' A.F.F..
12. "B","F4E","F12E FIXTURES TO BE 15' A.F.F..
13. 11'-0" TO BOTTOM OF FIXTURE. VERIFY PENDANT LENGTHS BEFORE ORDERING.
14. 7'-10" TO BOTTOM OF FIXTURE.
15. 14'-3" TO BOTTOM OF FIXTURE.

CONSTRUCTION SET
6/11/13

STATE OF OREGON ELECTRICAL SUPERVISOR
LIC# 37105
David R. Bulkley
EXPIRES 10/1/13

TOMCO ELECTRIC INC
850 NW BOND STREET, BEND OR 97701
541.389.5424 FAX 541.317.0494

EXPANSION AND REMODEL FOR. LITHIA HONDA OF BEND
2225 NE HIGHWAY 20
BEND, OREGON

NEAL HUSTON & ASSOCIATES ARCHITECTS INC.

520 SW Powerhouse Dr.
Suite 621
Bend, Oregon 97702
541.389.0991
FAX 541.389.1344
info@nealhuston.com
www.nealhuston.com

Copyright © 2012 by
Neal Huston & Associates Architects Inc.

REVISIONS

	DATE	DESCRIPTION
1	7/5/13	REVISED CONF/TRAINING RM.
2	.	.
3	.	.
4	.	.
5	.	.
6	.	.

DRAWINGS:
LIGHTING PLAN
.
.
.

PROJECT #: .
CAD FILE:
SCALE: 1/8" = 1'-0"
START DATE: 10/12/12
DRAWN BY: TIM/TM

E1.1